
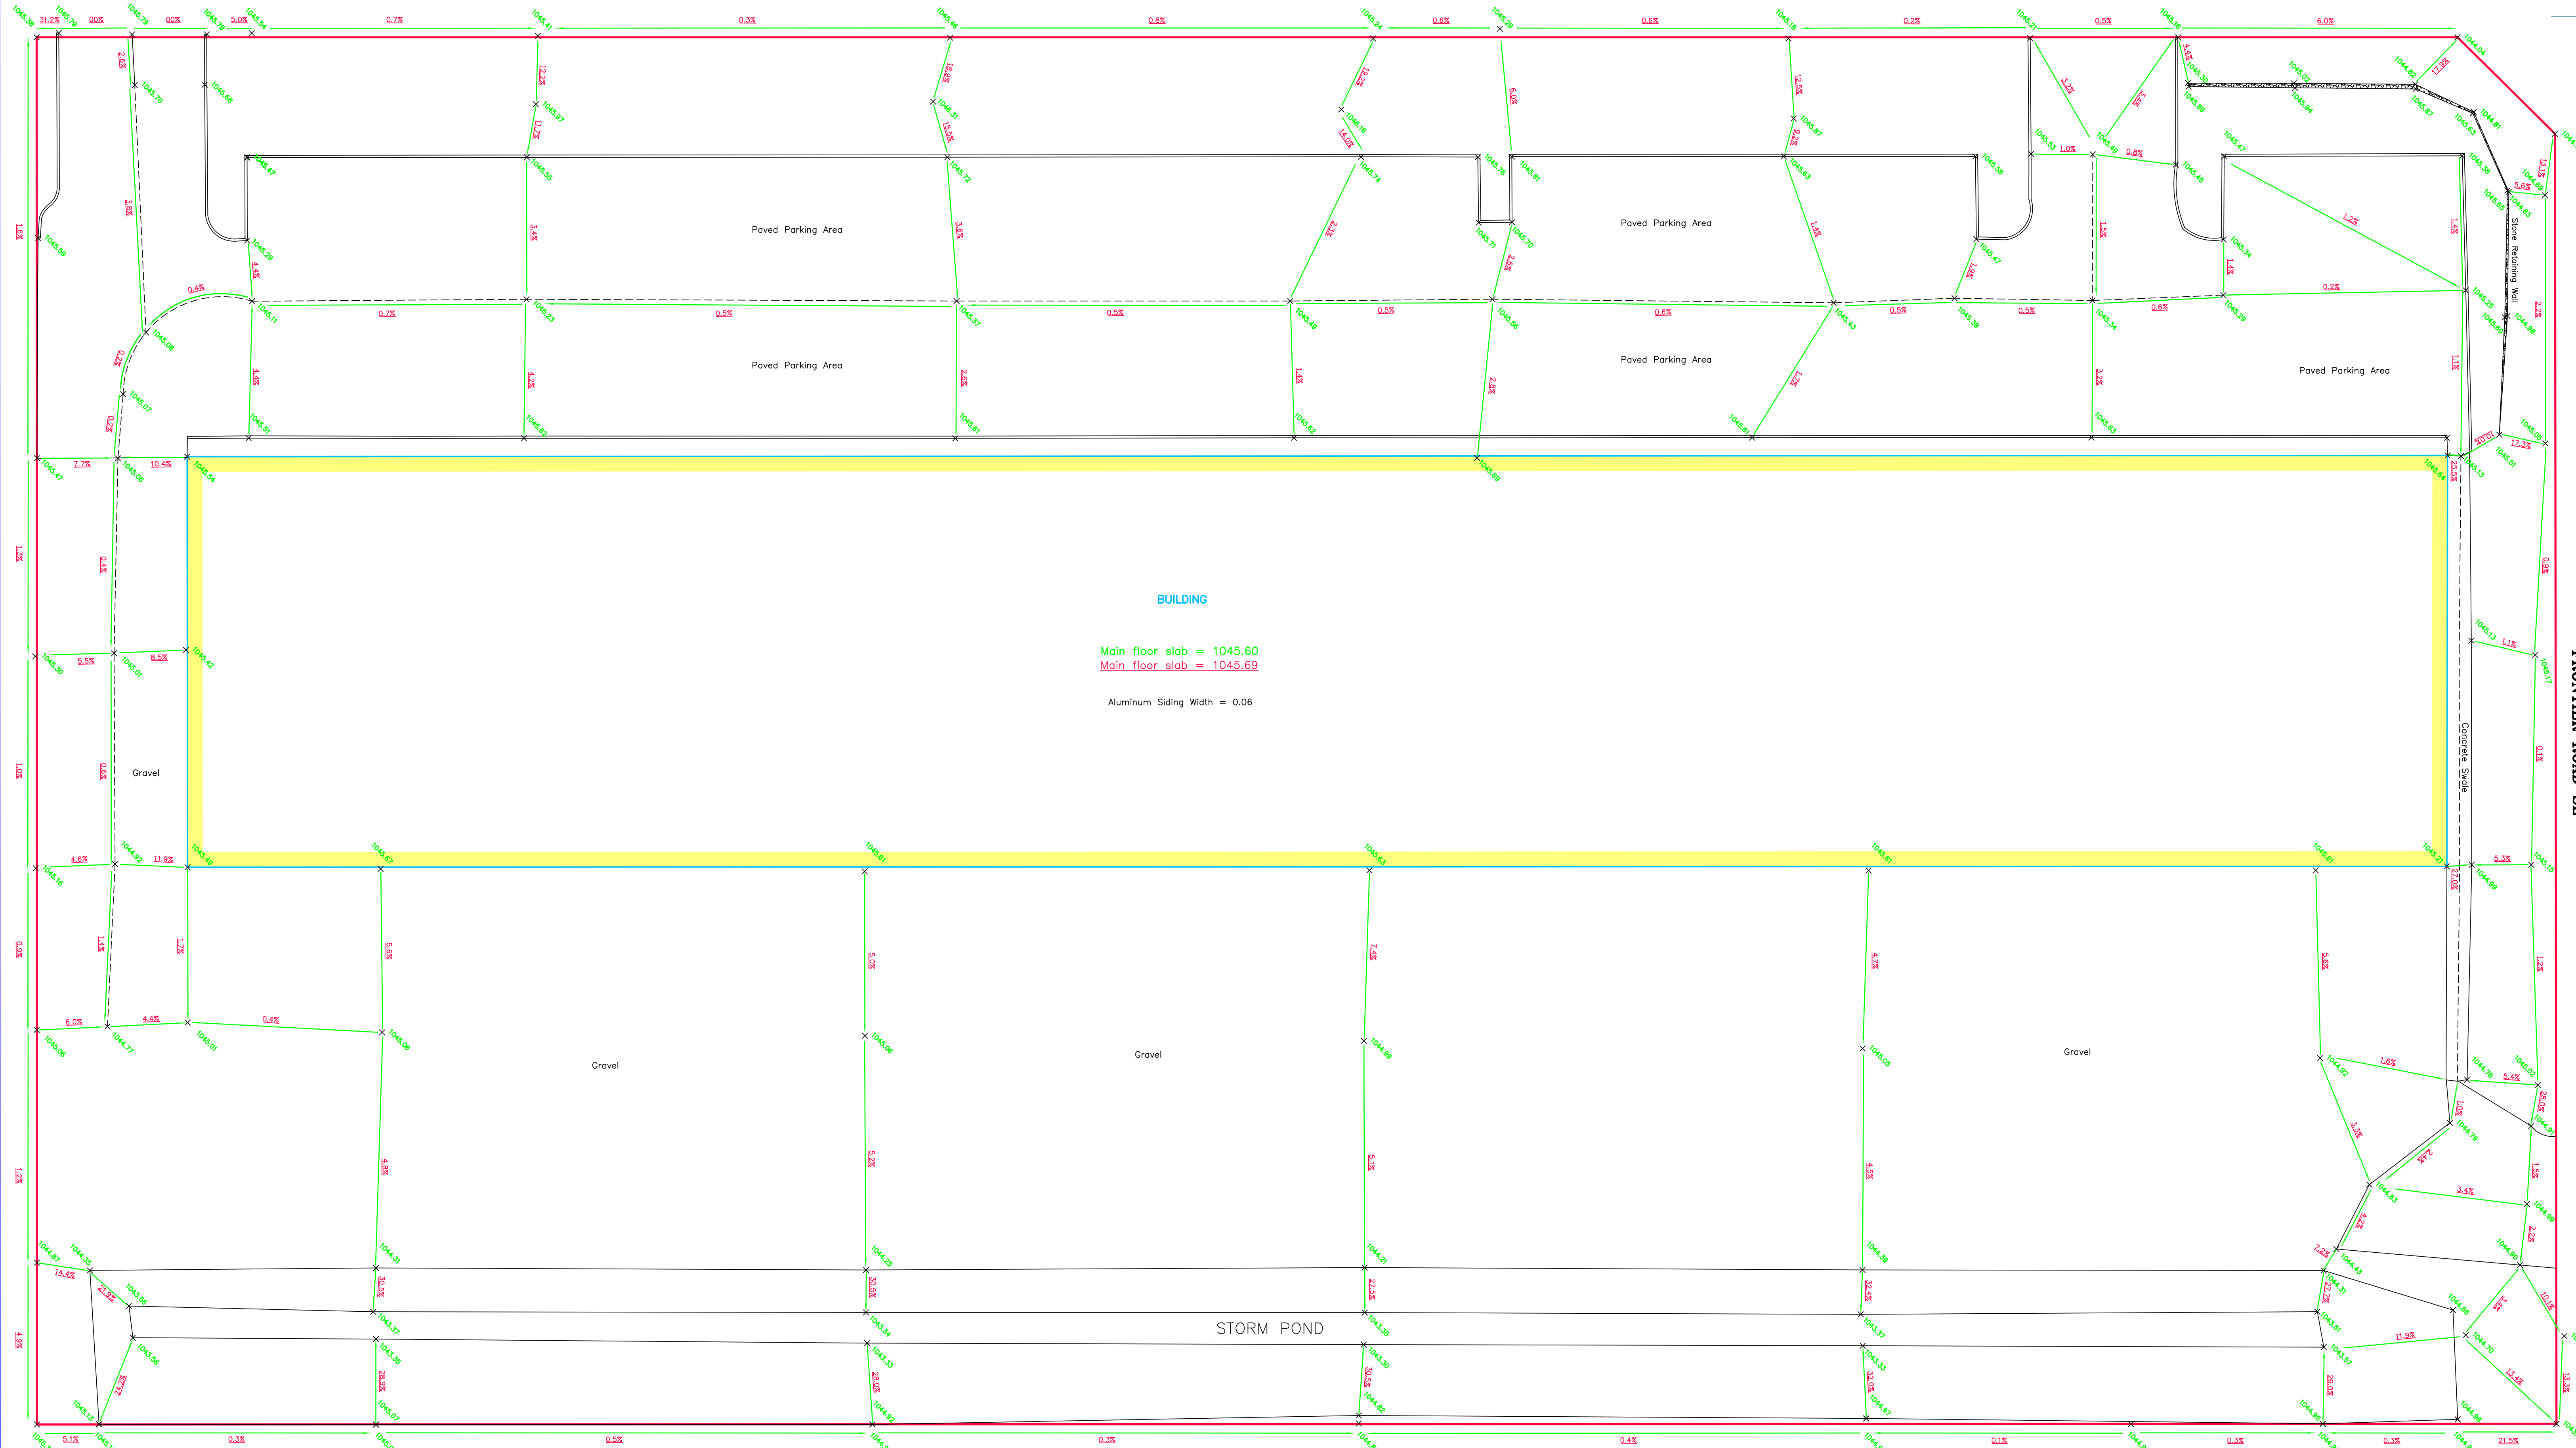


FRONTIER PLACE

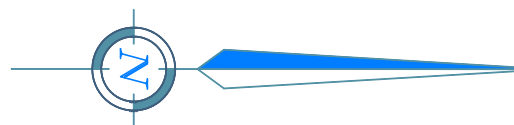

BUILDING
 Main floor slab = 1045.60
 Main floor slab = 1045.69
 Aluminum Siding Width = 0.06

FRONTIER ROAD SE

GRADING PLAN		
SITE ADDRESS		
240040 Frontier Place SE		
LOT 8	BLOCK 2	PLAN 081 4268
CLIENT NAME Acre Properties Ltd.		

Curtis Henrie, A.L.S.

Scale = 1 : 200

NOTES
 Slopes percentages are shown thus ... 10.0%
 As built grades are metric and shown thus ... 100.00
 Derived from ASCM121731...1040.600
 Drawn by: H. Galgandino

PREPARED BY: **VISTA GEOMATICS**
VISTA GEOMATICS LTD.
 DATE: December 1st, 2009
 Bay 1, 2135 - 32nd Avenue N.E.
 Calgary, Alberta T2E 6Z3
 Phone (403) 270-4048
 VISTA FILE NO. 09S115271